



1 GROUND FLOOR PLAN
1" = 10'-0" N

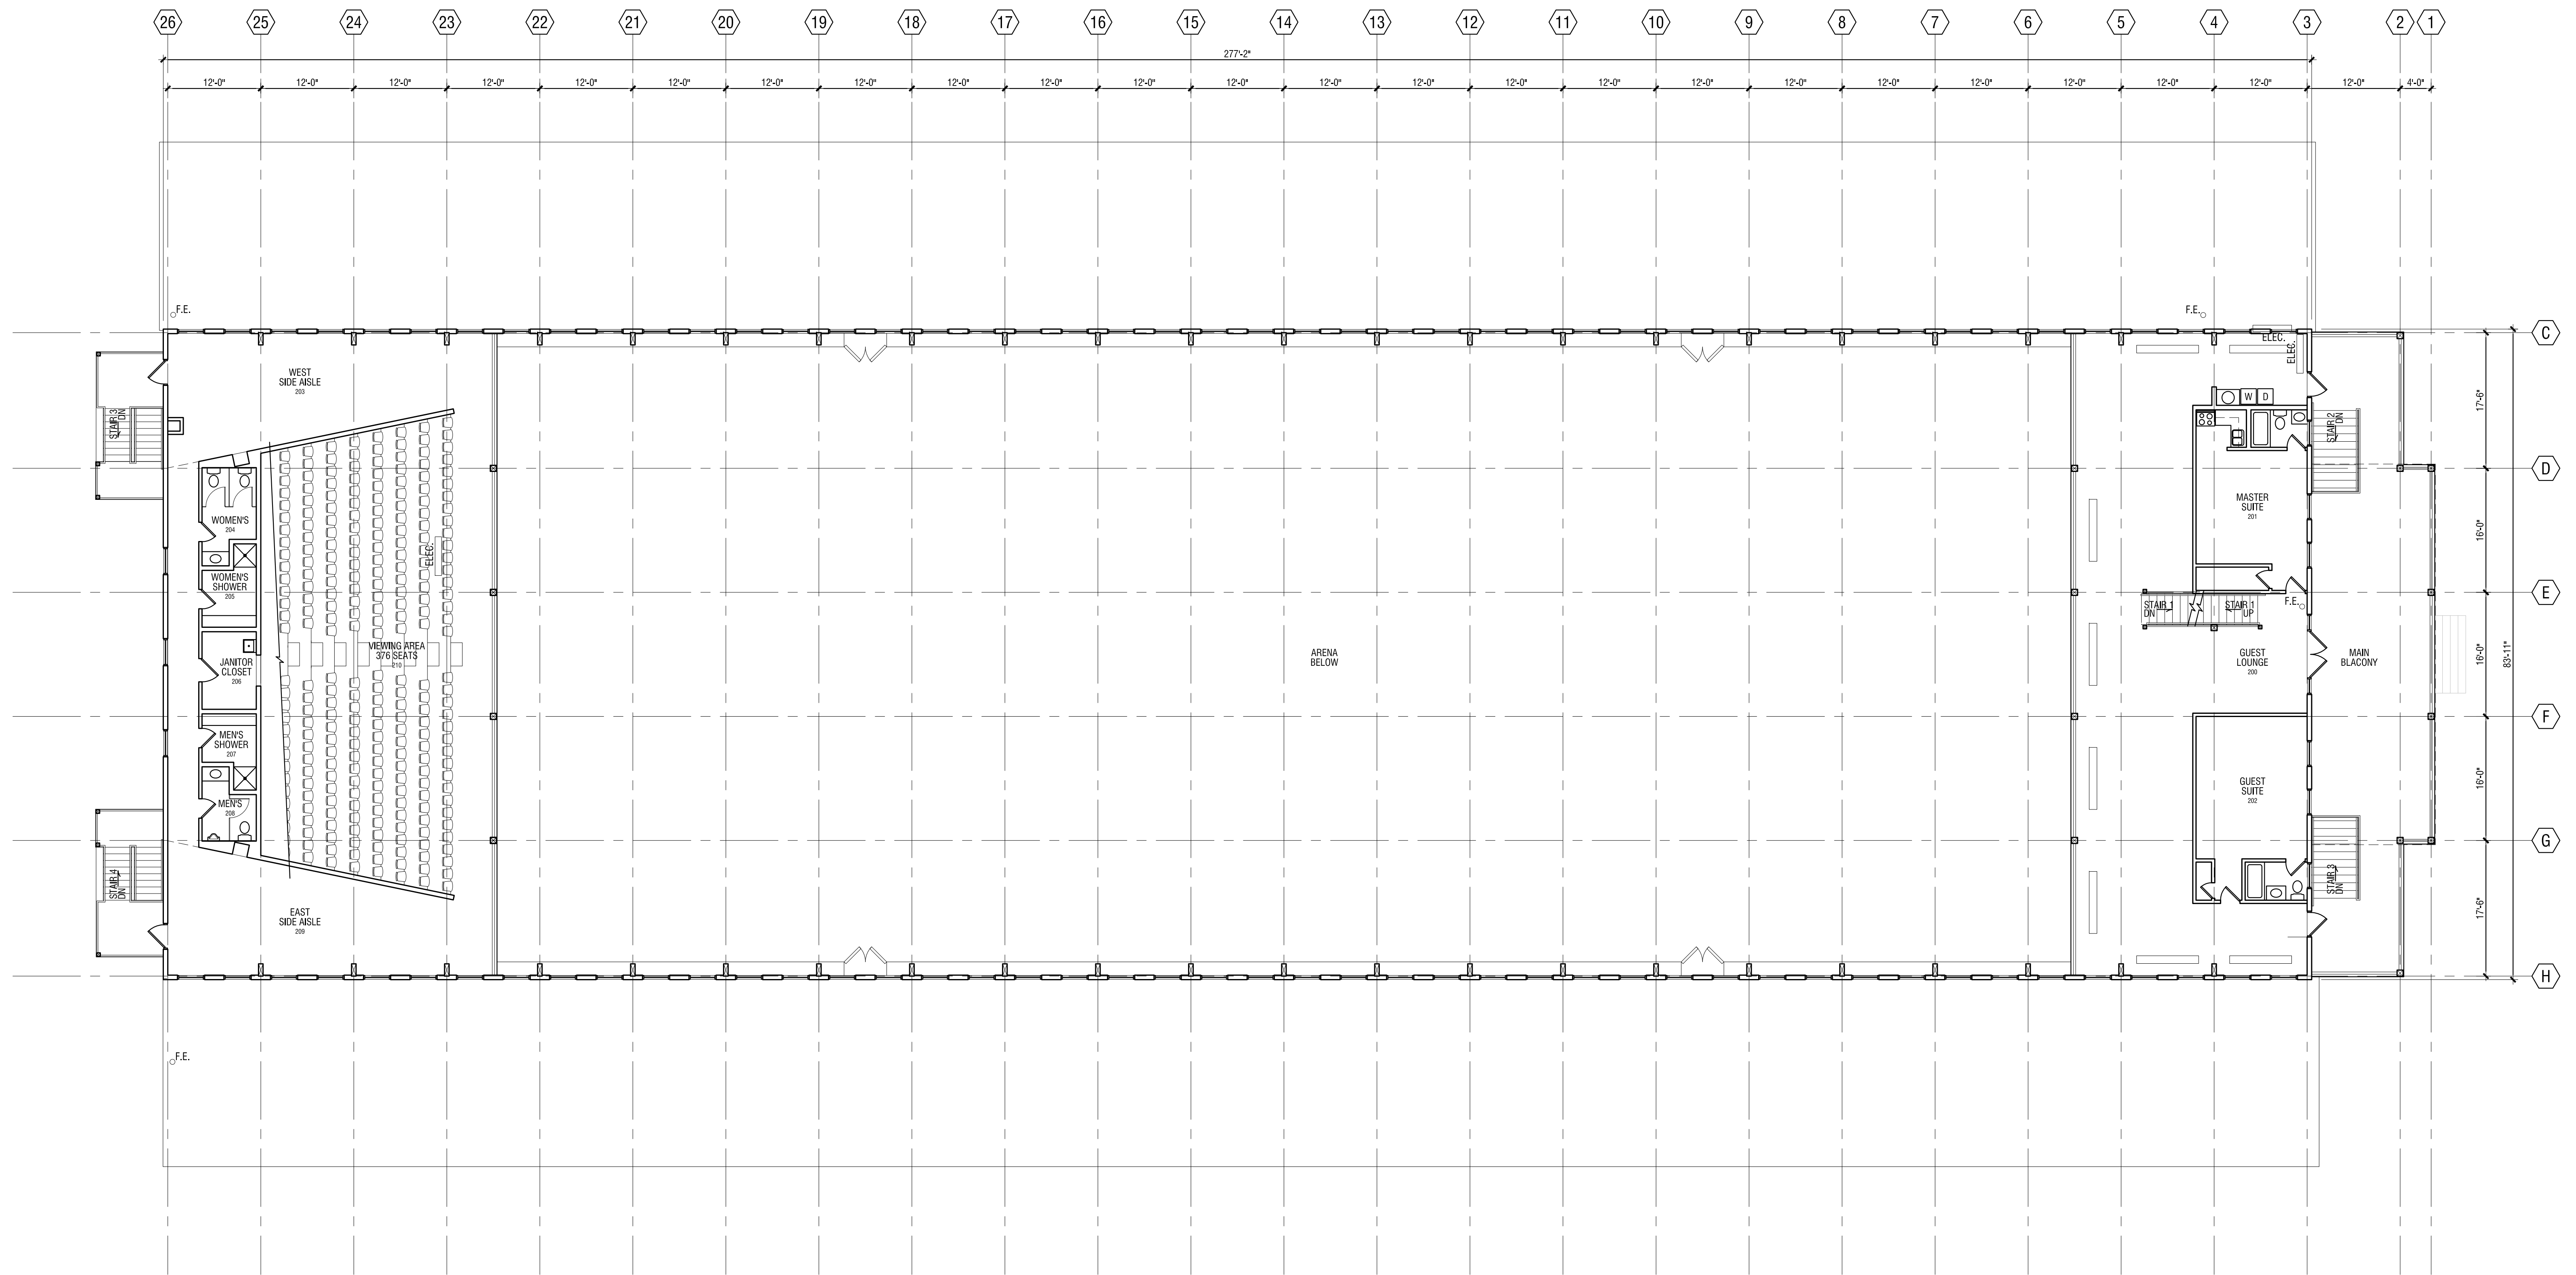

1 SECOND FLOOR PLAN
 1" = 10'-0"

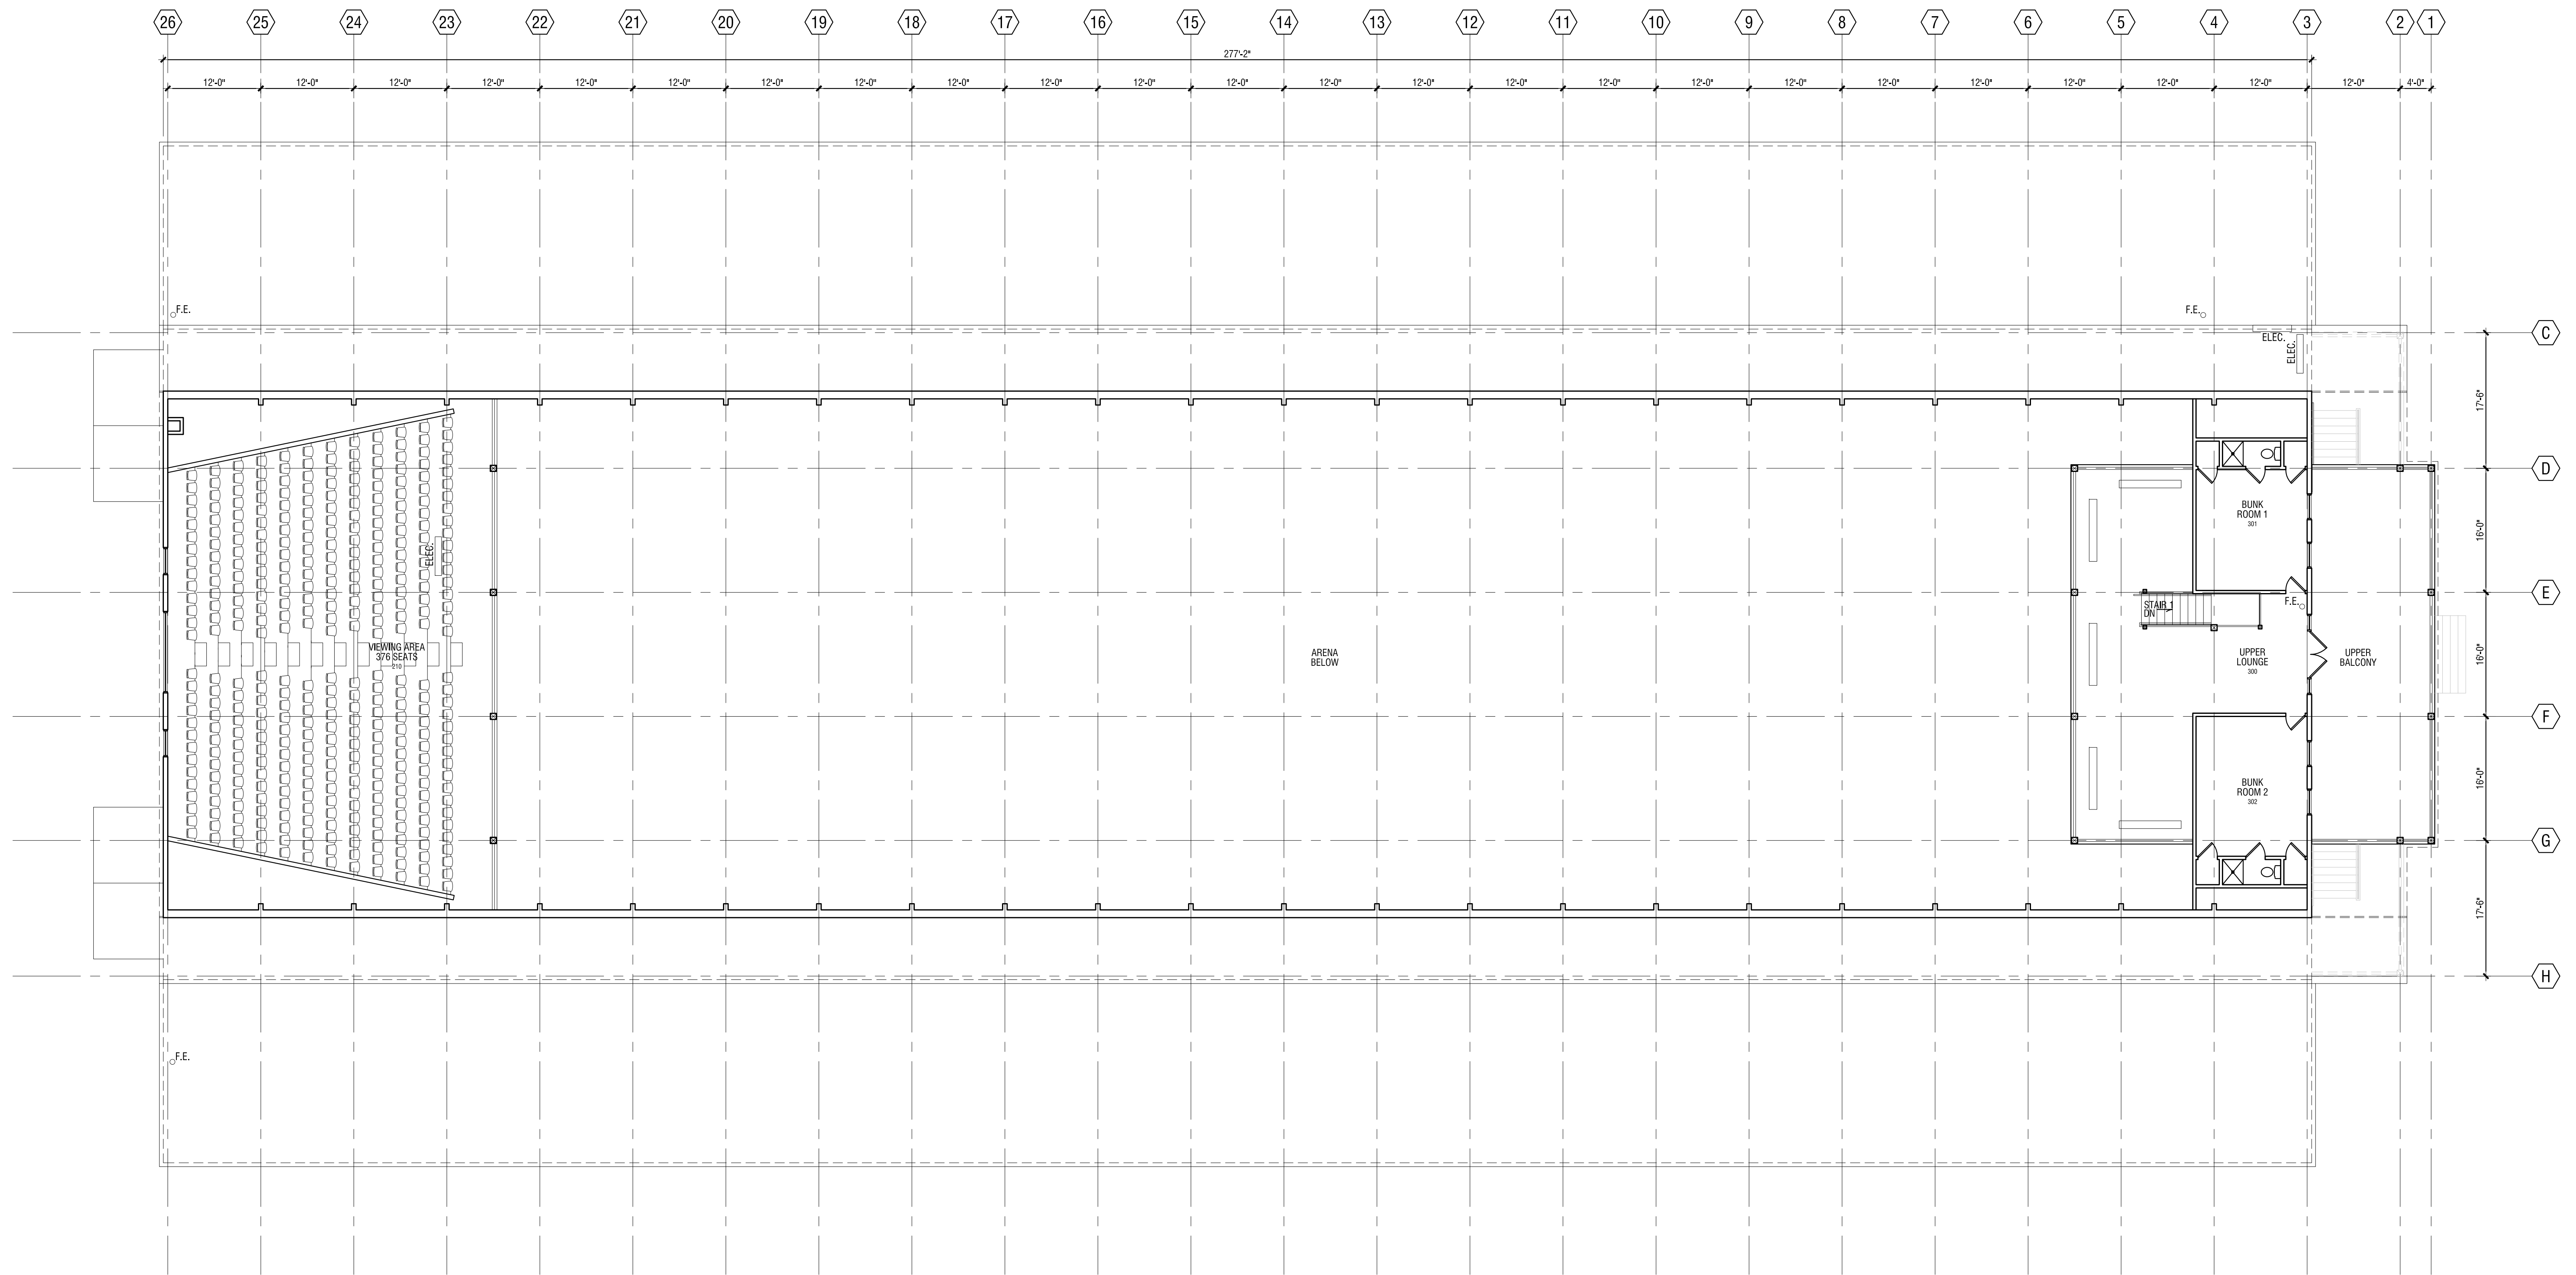

1 THIRD FLOOR PLAN
1" = 10'-0"

